


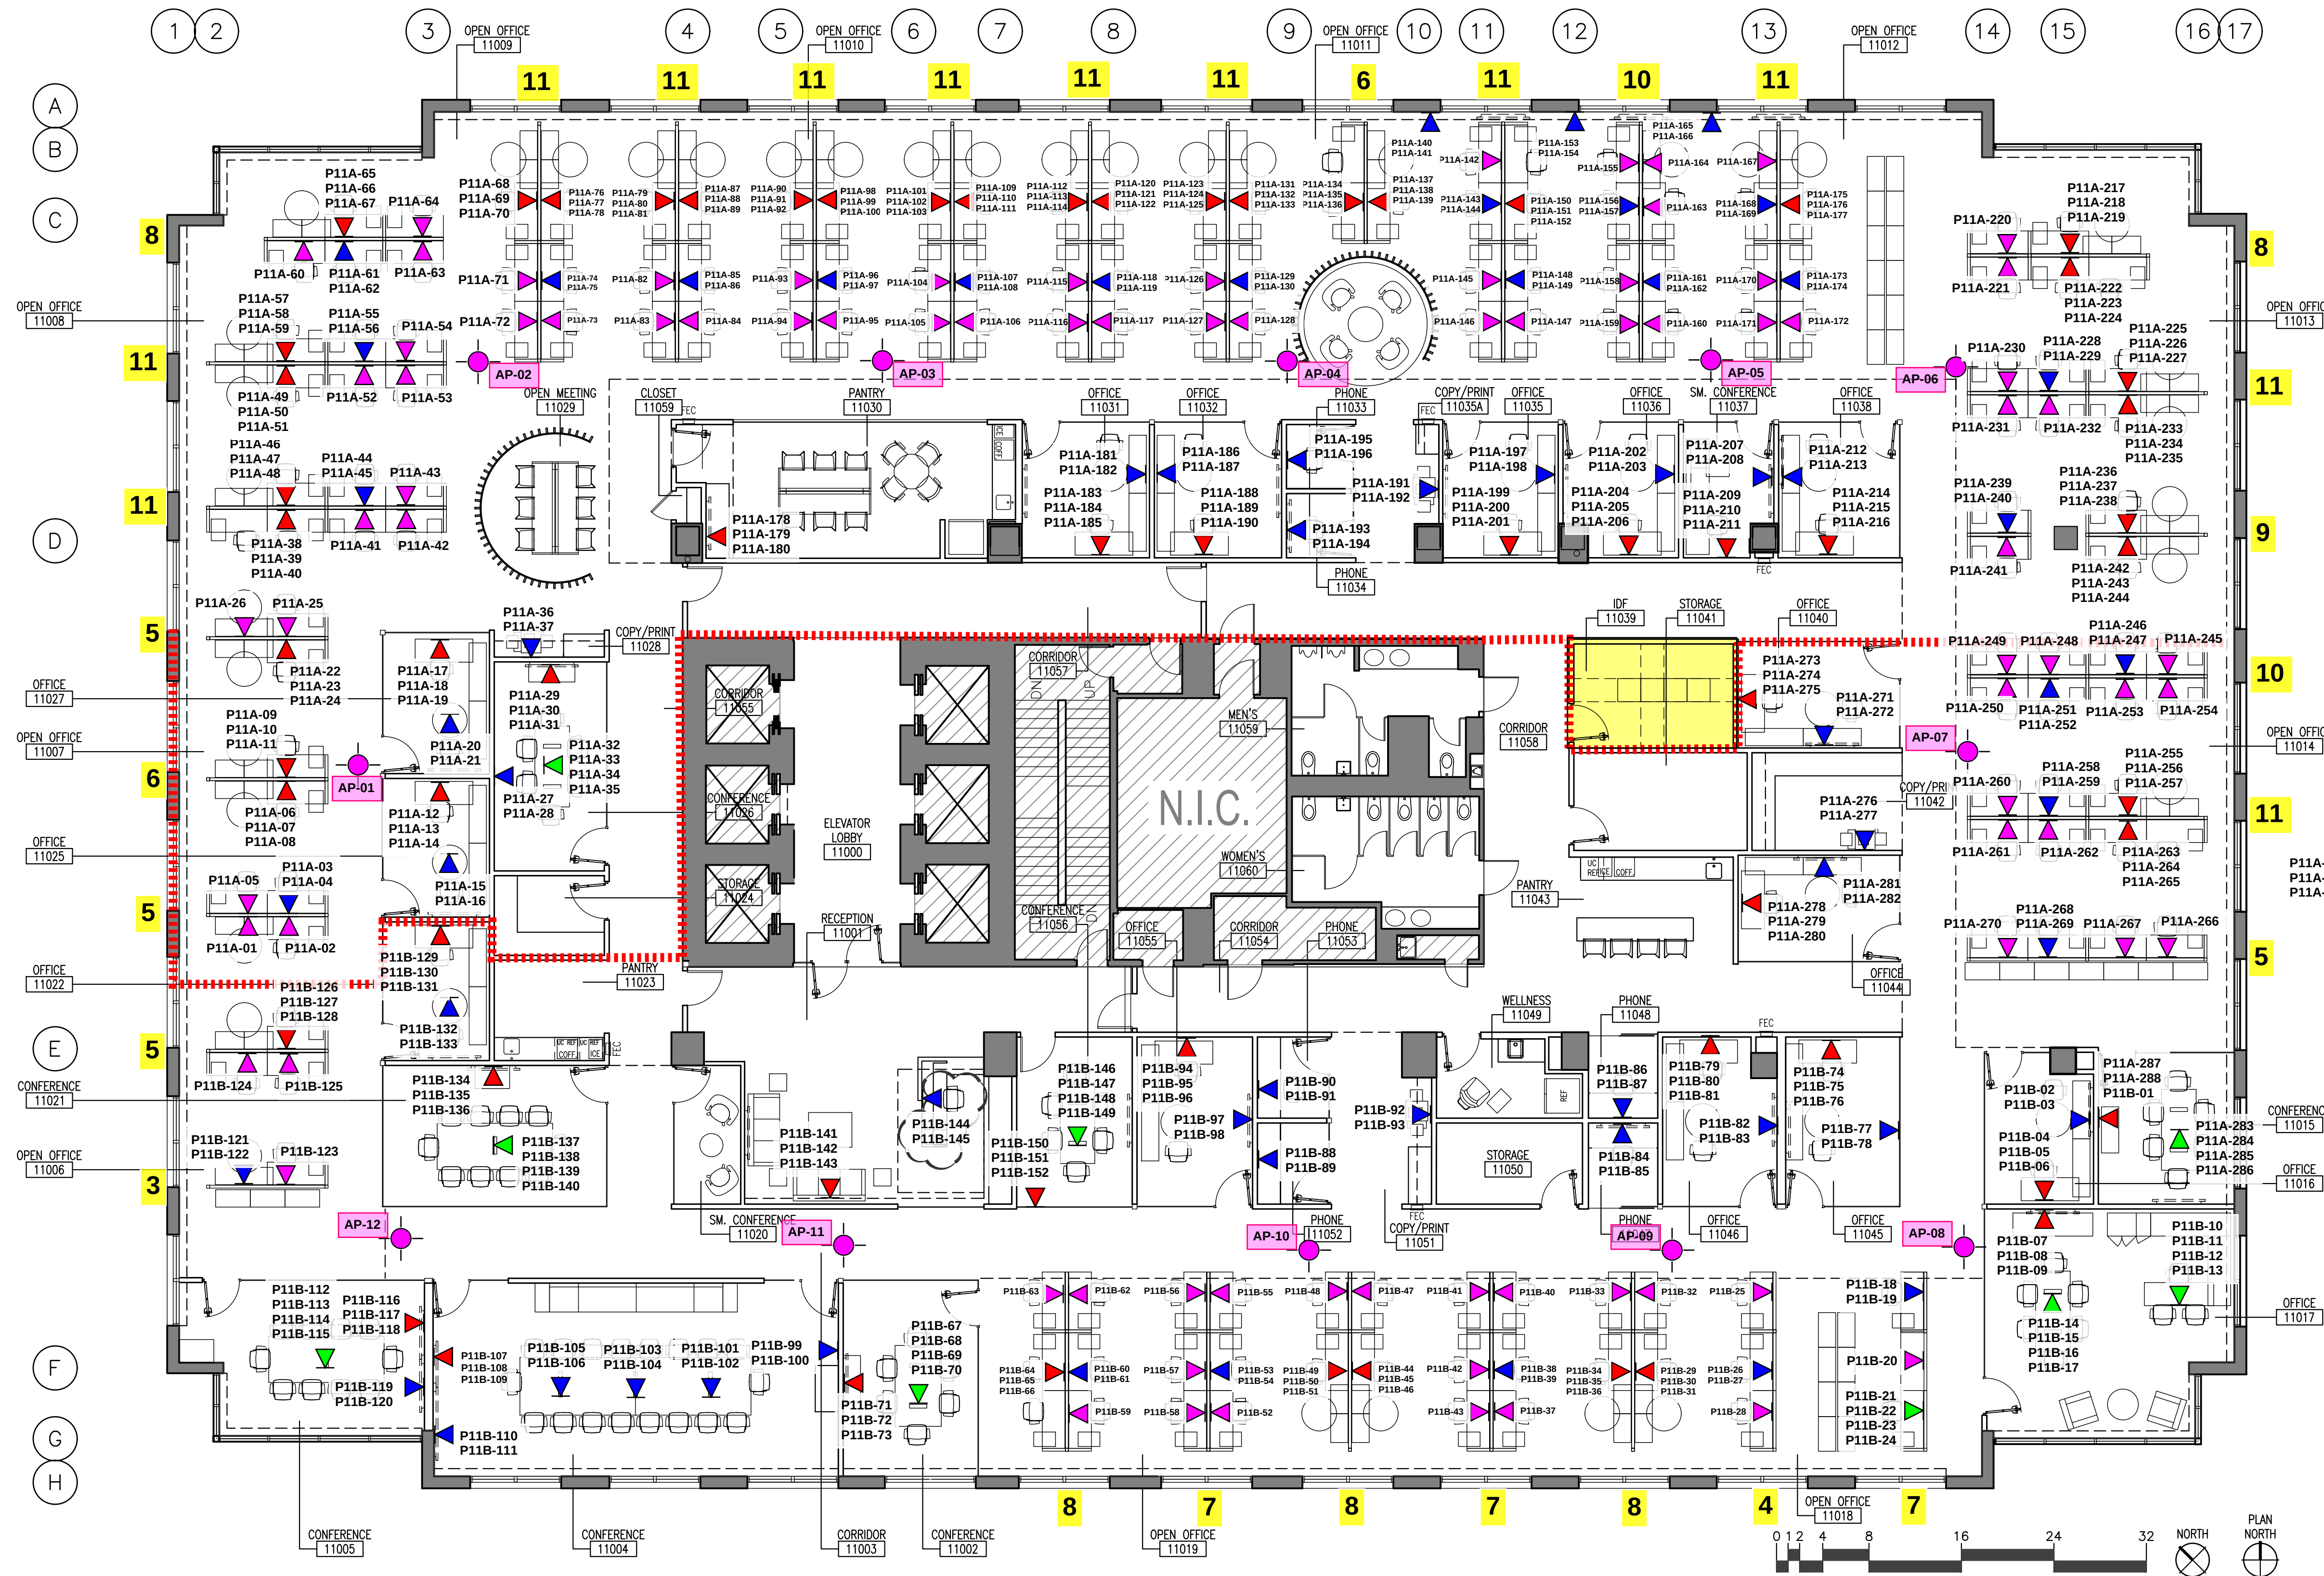


01 FURNITURE PLAN - 11TH FLOOR

SCALE: 1/8" = 1'-0"

Legend

Description	Quantity	Comments
AP	12	Single Cat 6
Dual Data Drop	64	Cat6
Quad Data Drop	9	Cat6
Single Data Drop	87	Cat6
Triple Data Drop	63	Cat6

Number of Cables per Table

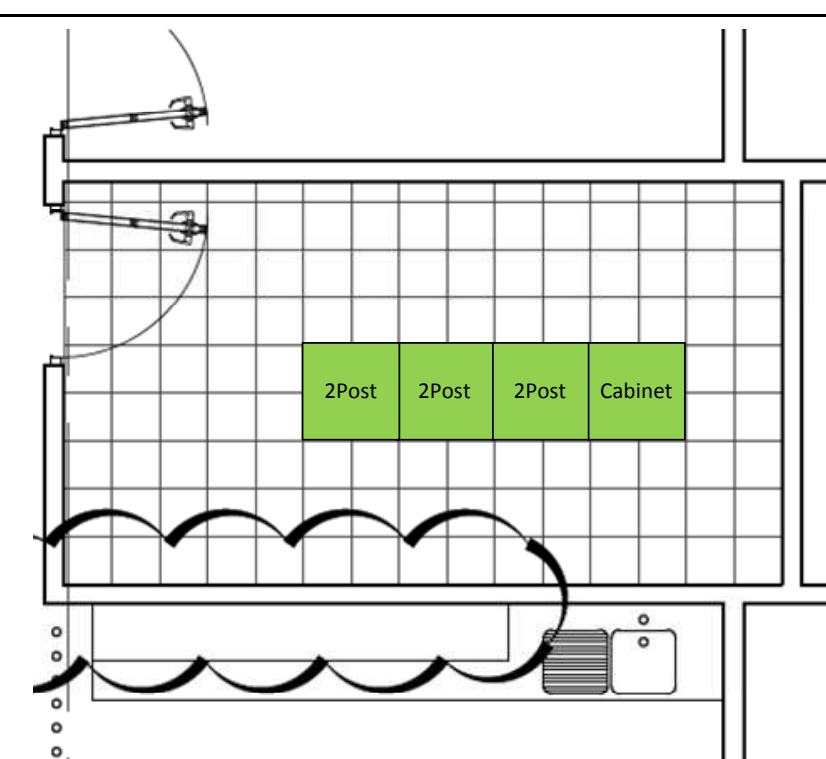

PLAN @ 11 FL IDF ROOM

KEY NOTES:

Description	Date
Scale	
Project No.	
Project	

Drawing

A5.11

Stamp